


EXCEPT AS MAY BE OTHERWISE PROVIDED BY CONTRACT, THESE DRAWINGS AND SPECIFICATIONS ARE THE PROPERTY OF "D-2 INCORPORATED", ARE ISSUED IN STRICT CONFIDENCE, AND SHALL NOT BE REPRODUCED, COPIED, OR USED AS THE BASIS FOR THE MANUFACTURE OR SALE OF APPARATUS WITHOUT PERMISSION.

DWG NO.		SH	REV	1
REVISIONS				
ZONE	REV	DESCRIPTION	DATE	APPROVED
-	-	ERN 07-003	12/28/07	SWS
1	1	EXTEND SENSOR ON FLANGE WELDMENT	14OCT11	AJF

RECOMENDED MOUNT FLANGE DESIGN

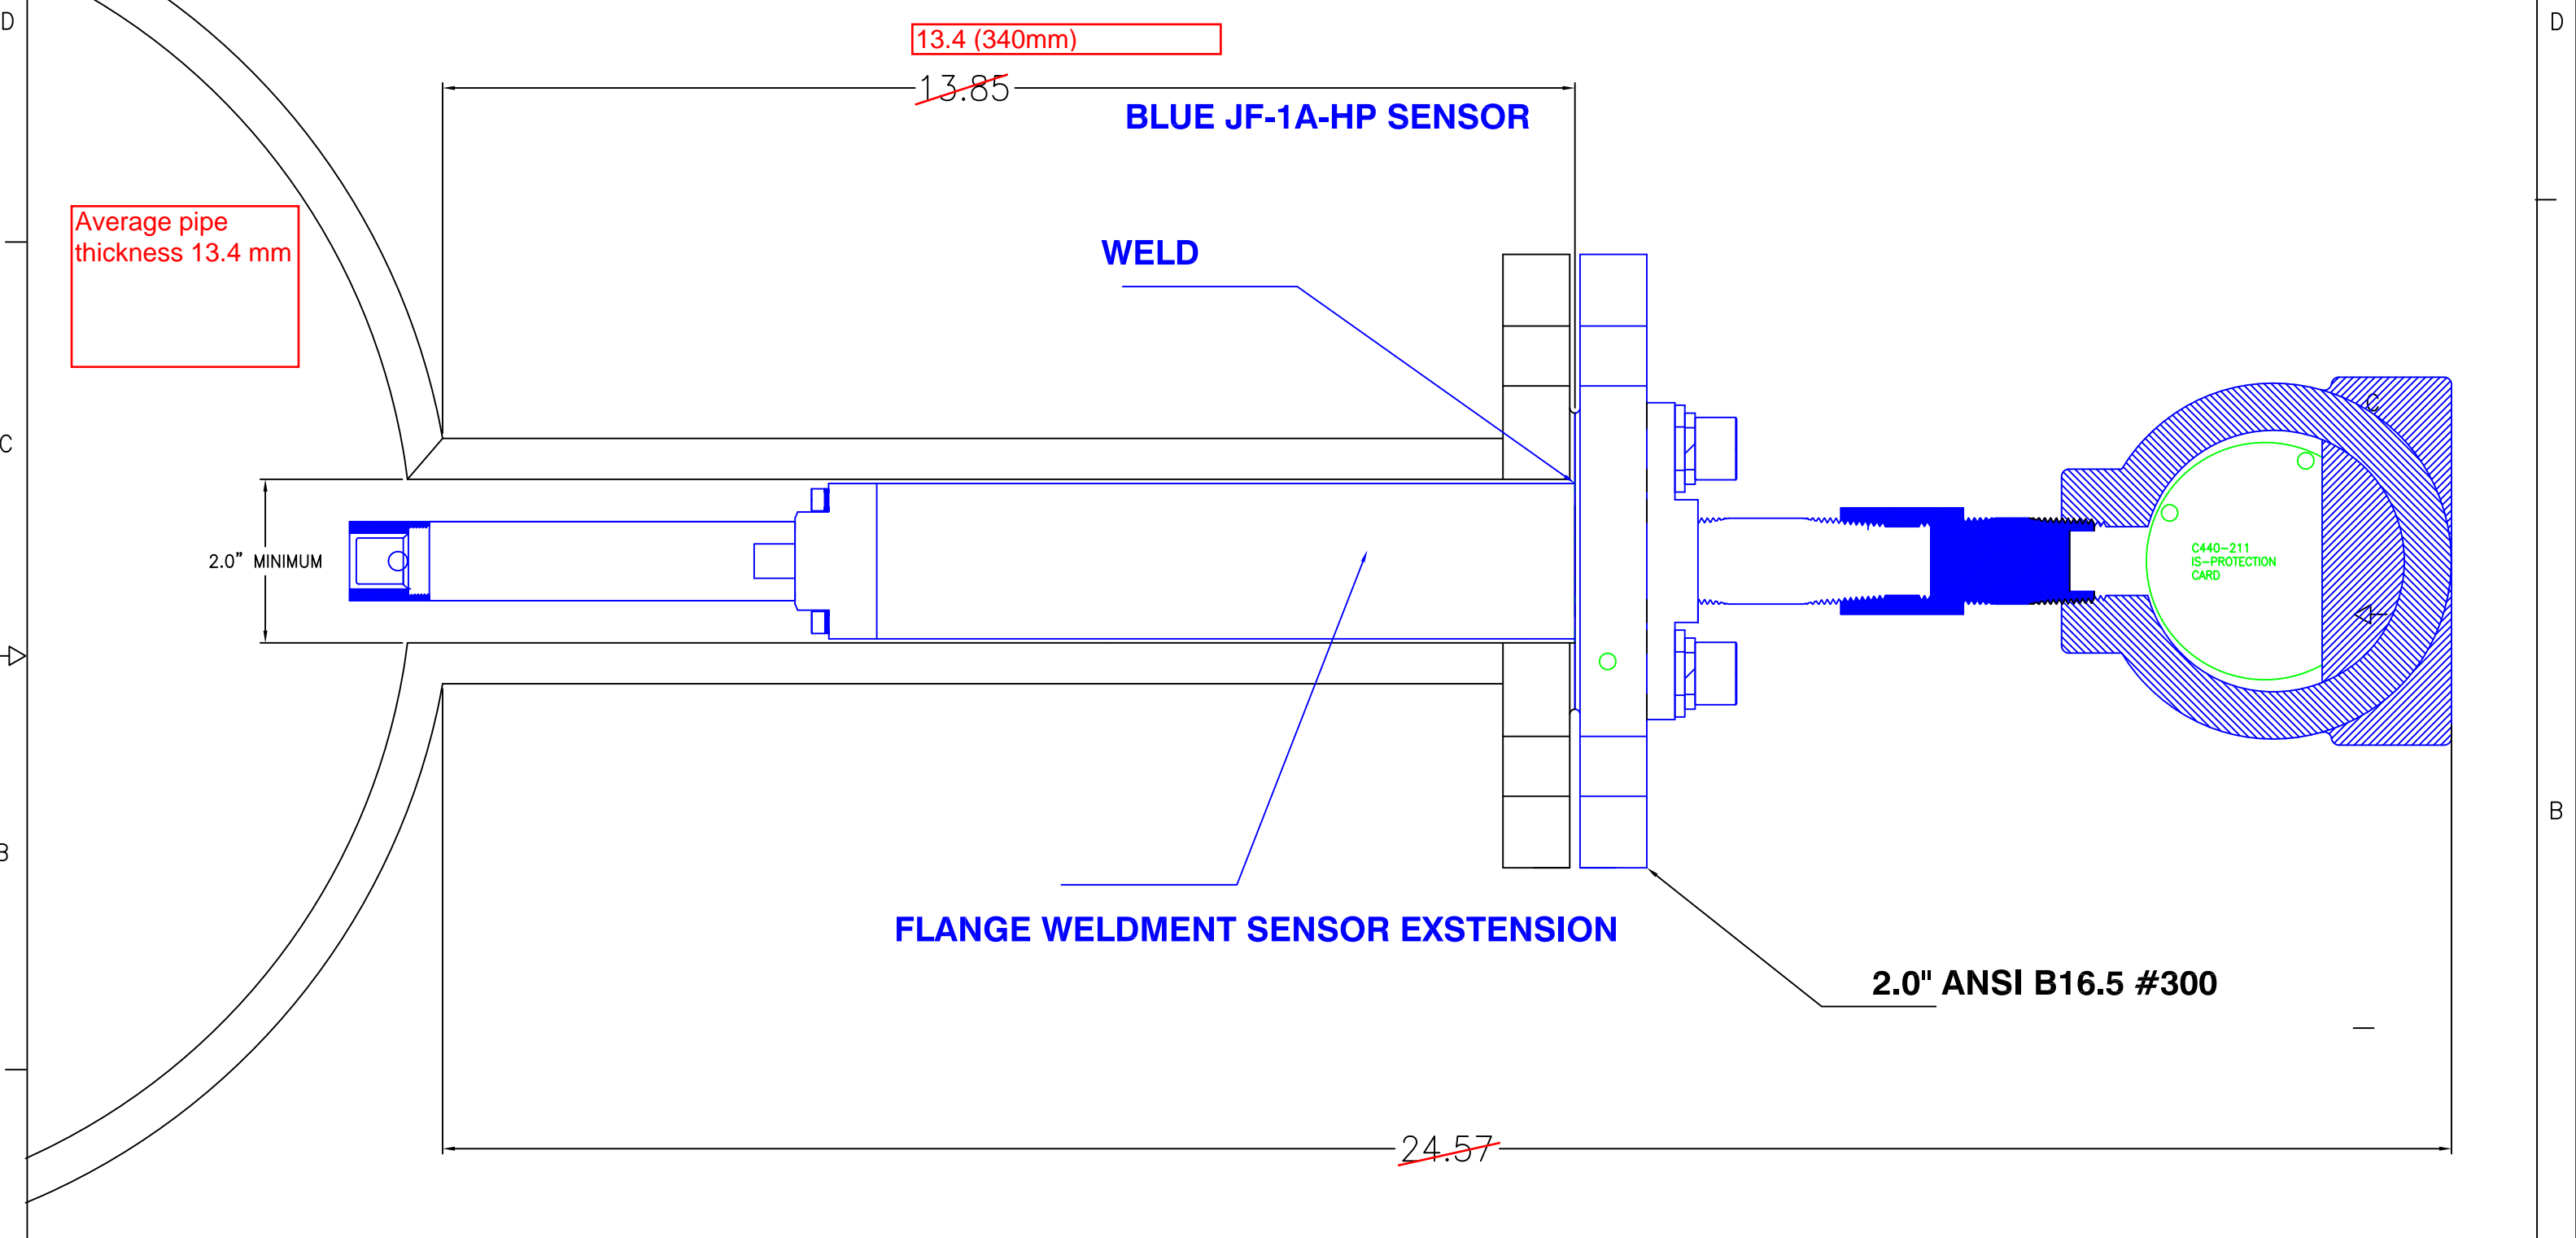

Average pipe thickness 13.4 mm

13.4 (340mm)

~~13.85~~

BLUE JF-1A-HP SENSOR

WELD

2.0" MINIMUM

FLANGE WELDMENT SENSOR EXSTENSION

2.0" ANSI B16.5 #300

C440-211 IS-PROTECTION CARD

~~24.57~~

MATERIAL	UNLESS OTHERWISE NOTED: DIMENSIONS ARE IN INCHES RESISTORS ARE IN OHMS CAPACITORS ARE IN MICROFARADS		APPROVALS		SIGNATURE & DATE		 D-2 INCORPORATED TITLE LAYOUT, JF-1A-HP, 2" ANSI #300 115 MM STEM
	FINISH	TOLERANCES			DRAWN	S. SAYLES	
DECIMALS		FRACTIONS	ANGLES	CHECKED		MECH ELECT SYSTEM FILENAME:	
2 PLACES		3 PLACES					
	±.01	±.005	±1/64	±1/2'	REMOVE BURRS, BREAK SHARP EDGES		DRAWING NO. D 443-057
							REV 1